



JEFFERSON COUNTY PURCHASING DEPARTMENT
Deborah L. Clark, Purchasing Agent

1149 Pearl Street
1st Floor, Beaumont, TX 77701

OFFICE MAIN: (409) 835-8593
FAX: (409) 835-8456

Addendum to IFB

IFB NUMBER: IFB 24-062/MR

IFB TITLE: Jefferson County Diversion Center Renovation

IFB DUE BY: **11:00 am CT, Wednesday, November 13, 2024**

ADDENDUM NO.: 3

ISSUED (DATE): November 6, 2024

To Bidder: This Addendum is an integral part of the IFB package under consideration by you as a Bidder in connection with the subject matter herein identified. Jefferson County deems all sealed bids to have been proffered in recognition and consideration of the entire IFB Specifications Package – *including all addenda*. For purposes of clarification, **receipt of this present Addendum by a Bidder should be evidenced by returning it (signed) as part of the Bidder's sealed bid submission**. If the bid submission has already been received by the Jefferson County Purchasing Department, Bidder should return this addendum in a separate sealed envelope, clearly marked with the IFB Title, IFB Number, and IFB Opening Date and Time, as stated above.

Reason for Issuance of this Addendum:

Vendor Questions

The information included herein is hereby incorporated into the documents of this present bid matter and supersedes any conflicting documents or portion thereof previously issued.

Receipt of this Addendum is hereby acknowledged by the undersigned Respondent:

ATTEST:

Authorized Signature (Respondent)

Witness

Title of Person Signing Above

Witness

Typed Name of Business or Individual

Approved by _____ Date: _____

Address



JEFFERSON COUNTY PURCHASING DEPARTMENT
Deborah L. Clark, Purchasing Agent

1149 Pearl Street
1st Floor, Beaumont, TX 77701

OFFICE MAIN: (409) 835-8593
FAX: (409) 835-8456

1. Question: Will there be background checks on this project? Any security protocols we need to be aware of to get on site?

Answer: Background checks will be required. Contractor will have to be let in and out of the secure facility until the fence has been relocated. Contractor staff must stay contained to the construction site. This is a non-smoking facility.

2. Question: Refer to 5/ A.151, is the intention to use the same Schluter transition of Sheet vinyl to LVT for where LVT.1 & LVT.2 / LVT.1 & LVT.3 meet?

Answer: See Brave answers beginning on page 3 of this addendum.

3. Please clarify the desired floor finishes for Mechanical rooms, Custodial rooms, Service Rooms, Sprinkler Room, & Staff Toilet D107. Its not clear on the finish plan.

Answer: See Brave answers beginning on page 3 of this addendum.



ADDENDUM # 02

IFB 24-062/MR Jefferson County Diversion Center Renovation

B/A No. 23141

Issue Date: 11/05/2024

Notice:

- Receipt of this Addendum shall be acknowledged on the Bid Form.
- This Addendum forms part of the Contract Documents for the above referenced project and shall be incorporated integrally therewith.
- Bidder shall make necessary adjustments and submit his/her proposal with full knowledge of all modifications, clarifications, and supplemental data included therein. Where provisions of the following supplemental data differ from those of the original Contract Documents, this addendum shall govern and take precedence.
- Identified items revised on the Drawings are designated by a cloud line surrounding the revised section of the drawing and a delta (Δ) symbol with the corresponding revision number.
- Items revised in the Project Manual are shown in bold AND italicized.

Modifications:

A. Changes to Bidding Information (questions & clarifications): RFIs

1. Sergio Gomez, Construction Managers of Southeast Texas, LLC Question 1 – Refer to 5/A.151, is the intention to use the same Schluter transition of sheet vinyl to LVT for where LVT.1 & LVT.2/LVT.1 & LVT.3 meet?

Response: Yes

2. Sergio Gomez, Construction Managers of Southeast Texas, LLC Question 2 – Please clarify the desired floor finishes for Mechanical rooms, custodial rooms, Service Rooms, Sprinkler Room, & Staff Toilet D 107. It's not clear on the finish plan.

Response: See revised sheet A.151 and A.152 with finish information.

3. Jesus Cardenas, Construction Managers of Southeast Texas, LLC Question 1 – Addendum 01 notes to reference revised Sheet A.101 to a response on some of the questions but there does not seem to be A.101 sheet attached to Addendum 01.

Response: See revised sheet A.101, A.102 and A.150 with all Toilet Accessories Tags and product information.

4. Plumbing drawings revisions in Addendum 01.

Response: New roof plan P1.3 shows roof gutters sized at 8"x6" minimum and 6" downspouts minimum (16 total downspouts). Sheet P1.1 shows 6" downspouts down through wall and terminate with downspout nozzle JR Smith 1770 or equal.

A. Attachments:

| Drawing Sheet | | Format | Date |
|---------------|--------------------------------|--------|------------|
| G.000 | Cover Page | 30x42 | 11/05/2024 |
| G.001 | Index and General Information | 30x42 | 11/05/2024 |
| A.101 | Enlarged Floor Plan – POD 200 | 30x42 | 11/05/2024 |
| A.102 | Enlarged Floor Plan – POD 400 | 30x42 | 11/05/2024 |
| A.150 | Finish Schedule | 30x42 | 11/05/2024 |
| A.151 | Finish Plan | 30x42 | 11/05/2024 |
| A.152 | Enlarged Finish Plan – POD 200 | 30x42 | 11/05/2024 |

End of Addendum 02 Narrative

4200 Montrose Blvd.
Suite 400
Houston, TX 77006

(IFB 24-062/MR) Jefferson County Diversion Center Renovation ADDENDUM NO. 3

bravearchitecture.com



JC DIVERSION CENTER RENOVATION

3890 FM3514, BEAUMONT, TX 77705

BRAVE / architecture

4200 Montrose Blvd., Suite 400
Houston, Texas 77006
713.524.5858 v / 713.524.5868 f
studio@bravearchitecture.com

B/A PROJ. 23141
#:

SCHEMATIC DESIGN

DESIGN DEVELOPMENT

90% CONSTRUCTION DOCUMENTS

100% CONSTRUCTION DOCUMENTS

ADDENDUM #01

ADDENDUM #02

05/02/2024
06/14/2024
08/23/2024
09/23/2024
11/01/2024
11/05/2024

1
2



100% CONSTRUCTION DOCUMENTS ADDENDUM #01

PROJECT TEAM:

| | |
|-------------------|-------------------------|
| ARCHITECT | BRAVE / ARCHITECTURE |
| CIVIL | DALLY + ASSOCIATES |
| LANDSCAPE | KW LANDSCAPE ARCHITECTS |
| STRUCTURAL | DALLY + ASSOCIATES |
| MEP | ASEI ENGINEERING |
| BUILDING ENVELOPE | PRICE CONSULTING, INC |
| AV/IT CONSULTANT | DATACOM DESIGN GROUP |



CIVIL
DALLY + ASSOCIATES
9800 RICHMOND AVE SUITE 460
HOUSTON, TEXAS 77042
Civil Contact

LANDSCAPE
KV LANDSCAPE ARCHITECTS
6925 PORTWEST DRIVE, SUITE 100
HOUSTON, TX 77024
Landscape Contact

STRUCTURAL
DALLY + ASSOCIATES
9800 RICHMOND AVE, SUITE 460
HOUSTON, TEXAS 77042
Structural Contact

MEP
ASEI ENGINEERING
350 GLENBOROUGH DR, SUITE 270
HOUSTON, TX 77067
MEP Contact

BUILDING ENVELOPE
PRICE CONSULTING, INC
211 HIGHLAND CROSS DRIVE SUITE
200 HOUSTON, TX 77073
Consultant Contact

AV/IT CONSULTANT
DATACOM DESIGN GROUP
9111 JOLLYVILLE ROAD, SUITE 290
AUSTIN, TX 78759
Consultant Contact

Owning of Instruments of Service:
All documents and instruments prepared by BRAVE
ARCHITECTURE are instruments of service to the property
and shall retain all common law, statutory and other reserved rights, including
the copyright rights.

SEAL:



10/30/2024

FILE:
DRAWN BY:
CHECKED BY:
Author
Checker

ISSUE:
05/02/2024 SCHEMATIC DESIGN
06/14/2024 DESIGN DEVELOPMENT
08/23/2024 90% CONSTRUCTION
DOCUMENTS
09/23/2024 100% CONSTRUCTION
DOCUMENTS
1 11/01/2024 ADDENDUM # 01
2 11/05/2024 ADDENDUM #02

INDEX & GENERAL INFO

Scale: AS NOTED

G.001

| | | | |
|---------|--|------------------|------------------------------|
| AB | ANCHOR BOLT | JAN | JANITOR |
| ACOUS | ACOUSTICAL | JST | JOIST |
| AD | ACCES DOOR | JT | JOINT |
| ADA | ACCESSIBILITY DISABILITIES ACT | LAM | LAMPHOLD (D) |
| ADJ | ADJUSTABLE | LAV | LAVATORY |
| ADJ | ADJACENT | LGH | LENGTH |
| AFF | ABOVE FINISHED FLOOR | LIN | LINEAR |
| AGG | AGGREGATE | LIN | LINEAR |
| AHU | AIR HANDLING UNIT | LCKR | LOCKER(S) |
| ALT | ALTERNATE | LL | LIVE LOAD |
| ALUM | ALUMINUM | LT | LIGHT |
| AND | AND/OR | MCH | MACHINERY |
| ANOD | ANODIZED | MEM | MEMBRANE |
| ANOD | ANODIZED | MFR | MANUFACTURER |
| AP | APPROXIMATELY | MHR | MATERIAL |
| A-R | ACCESS PANEL | MIS | MISCELLANEOUS |
| ARCH | ARCHITECT (URAL) | MIS | MATERIAL |
| AS | AS AIN | MATL | MATERIAL |
| ASPH | ASPHALT | MAX | MATERIAL |
| ATN | ATTENUATION (ING) | MACH | MATERIAL |
| AUTO | AUTOMATIC | MACH BOLT | MATERIAL |
| AV | AVENUE | MCH | MATERIAL |
| AVG | AVERAGE | MEM | MEMBRANE |
| A/C | AIR CONDITIONING | MFR | MANUFACTURER |
| AV | AUDIO VISUAL | MHR | MATERIAL |
| BD | BOARD | MIS | MISCELLANEOUS |
| BLDC | BUILDING | MIS | MISCELLANEOUS |
| BLKS | BUILDING | MIS | MISCELLANEOUS |
| BK | BLOCK | MIS | MISCELLANEOUS |
| BM | BEAM | MIS | MISCELLANEOUS |
| BOT | BOTTOM | MIS | MISCELLANEOUS |
| BRS | BREAK | MIS | MISCELLANEOUS |
| BRKT | BRACKET | MIS | MISCELLANEOUS |
| BSMT | BASEMENT | MIS | MISCELLANEOUS |
| BTW | BETWEEN | MIS | MISCELLANEOUS |
| BUR | BUILT UP ROOFING | MIS | MISCELLANEOUS |
| BUR | BUILT UP BURLED | MIS | MISCELLANEOUS |
| B-B | BACK TO BACK | MIS | MISCELLANEOUS |
| B.M. | BENCH MARK | MIS | MISCELLANEOUS |
| B/F | BOTH FACES | MIS | MISCELLANEOUS |
| CAB | CABINET | OA | OVERALL |
| CB | CHALK BOARD | OC | ON CENTER (S) |
| CCTV | CLOSED CIRCUIT TELEVISION | OC | OUTSIDE DIAMETER |
| CO | CLOSED | OFF | OWNER FURNISHED / |
| CER | CERAMIC | ON | ON CONTRACTOR INSTALL |
| CFMF | COLD FORMED METAL FRAMING | OFF | OFFICE |
| CIP | CAST IN PLACE | OFO | OWNER FURNISHED / |
| CI PIPE | CAST IN PLACE PIPE | OFO | OWNER INSTALLED |
| CO | CONTROLO POINT | OH | OPPOSITE HAND |
| CKBD | CHAIRBOARD | OPN | OPENING |
| CLG | CEILING | OPN | OPENING |
| CLR | CLEAR (ANCE) | OPR | OPENING |
| CLT | CLOSE | OPR | OPENING |
| CMU | CONCRETE MASONRY UNIT | OA | OUTSIDE AIR |
| CNT | COUNTER | PA | PAINT |
| COL | COLUMN | PART | PARTITION |
| COMPRES | COMPRESS | PCF | POUNDS PER CUBIC FOOT |
| COMP | COMPOSITION | PCP | PORTLAND CEMENT PLASTER |
| COND | CONDENSATE | PERF | PERFORATED |
| COND | CONDITION | PLAM | PLASTIC LAMINATE |
| COND | CONDITION | PLAS | PLASTIC |
| CONST | CONSTRUCTION | PLBS | PLUMBING |
| CONTR | CONTRACTOR | PLWD | PLYWOOD |
| CONT | CONTINUOUS | PNL | PLATE |
| COUPL | COUPLED | POL | POLISHED |
| CORP | CORRIDOR | PRKG | PARKING |
| CSMT | CASEMENT | PR | PAIR |
| CTR | CENTER | REC | RECEIVER |
| CTSK | COATERSHINK | REC | RECEIVER |
| CT | CERAMIC TILE | REC | RECEIVER |
| CU FT | CUBIC FOOT (FEET) | PTD | PANTED |
| CU YD | CUBIC YARD | PVC | POLYVINYL CHLORIDE |
| C | CURB | PVG | PAVING |
| C.0 | CASE TO CENTER | PWT | PARTMENT |
| C.O. | CASED OPENING | P.L. | PROPERTY LINE |
| D6 | DRY MARKER BOARD | P.C. | PRECAST |
| DBL | DOUBLE | QT | QUARRY TILE |
| DEFL | DEFLECTION | R | RADIUS |
| DRINK | DRINKING FOUNTAIN | R/A | RETURN AIR GRILLE |
| DIAG | DIAGONAL | R/H | RIGHT HAND |
| DIM | DIMENSION | R/C | REFLECTED CEILING PLAN |
| DISC | DISCONNECT | RD | ROOF DRAIN |
| DISP | DISPENSER | REC | REINFORCING BAR |
| DL | DEAD LOAD | REC | REINFORCING |
| DMPFG | DAMPENING | RECIP | RECEPABLE |
| DN | DOWN | RECOM | RECOMMENDATION |
| DR | DOOR | REC | RECESSION |
| DS | DISPENSER | REC | RECEPTION |
| DTL | DETACH | REC | REMOVED |
| DW | DWY WALL | REC | REQUIRED |
| DWG | DRAWING | RES | RESILIENT |
| D | DEPTH | RET | RETURN |
| EA | EACH | REV | REVISION |
| EFOB | EXTERIOR FACE OF BUILDING | RE | REFER TO |
| EIFS | EXTERIOR INSULATED FINISH SYSTEM | RFG | ROOFING |
| ELD | EXTERIOR DOOR | RH | RIGHT HAND |
| ELAS | ELASTIC (ELASTOMERIC) | RIM | ROOM |
| ELEC | ELECTRICAL | ROW | RIGHT OF WAY |
| ELEV | ELEVATOR | R.T.U. | ROOF TOP UNIT |
| ELU | ELU | RUE | ROUTE |
| EMER | EMERGENCY | SCHED | SCHEDULE |
| EP | EXPLOSION PROOF | SECT | SECTION |
| EQUI | EQUIPMENT | SHD | SCHEDULE |
| ER | ERGONOMICS | SHD | SCHEDULE |
| ESR | ELASTIC SHEET ROOFING | SHLV | SHELVING (S) |
| EWC | ELECTRIC WATER COOLER | SHTH | SHETHING (S) |
| EWH | ELECTRIC WATER HEATER | SHT | SHET |
| EW | EACH WAY | SHWR | SHOWERS |
| EWSH | EWASH | SPC | SPECIFICATION |
| EXH | EXHAUST | SQ | SQUARE |
| EXIST | EXISTING | SS | STAINLESS STEEL |
| EXPAN | EXPANSION | STAB | STABILIZER (D) |
| EXT | EXTERIOR | STD | STANDARD |
| FA | FIRE ALARM | STL | STEEL |
| FO | FORE CODE | STR | STRUCTURE |
| FD | FLOOR DRAIN | STR | STRUCTURE (AL) |
| FEC | FEAR EXTINGUISHER CABINET | SUSP | SUSPENDED |
| FHC | FIRE HOSE CABINET | SUSP | SUSPENDED |
| FI | FIREFIGHTER | SW | SWITCH |
| FIN | FINISH (ED) | SYN | SYMMETRICAL |
| FIXT | FIXTURE | SYN | SYMMETRIC |
| FLRG | FLOORING | TAB | TAB |
| FLSG | FLASHING | TA | TEXTURE ACCESSORY |
| FLUOR | FLUORESCENT | T.A. | TEXTURE ACCESSORY |
| FL | FLOW LINE | T.COC | TEXTURED COATING ON CONCRETE |
| FM | FACTORY MUTUAL | T.C. | TOP OF CURB |
| FR | FLAME RETARDANT | TEL | TELEPHONE |
| FRPF | FIREFPROOF | TEM | TEMPERED |
| FSG | FULL SIZE | THK | THICKNESS |
| FTG | FOOTING | THICKNESS | THICKNESS |
| FT | FOOT (SET) | THRES | THRESHOLD |
| FURN | FURNISH | TR | TRACKBOARD |
| FUR | FURRED (ING) | TLT | TOILET (S) |
| F.V. | FIELD VERIFY | TRZ | TERAZZO |
| FVC | FIRE VALVE CABINET | TV | TELEPHONE TERMINAL CABINET |
| GAL | GALVANIZED | TV | TELEVISION |
| GAL | GALLOON | TOP | TOP |
| GA | GENERAL | UNO | UNLESS NOTED OTHERWISE |
| GG | GENERAL CONTRACTOR | UR | UNIVERSITY |
| GD | GRADE, GRADING | VAC | VACUUM |
| GEN | GENERAL | VCM | VINYL COMPOSITION TILE |
| GL | GLASS GLAZING | VERT | VERTICAL |
| GMU | GLASS MESH MORTAR UNIT | VEST | VESTIBULE |
| GMP | GUARANTEED MAXIMUM PRICE | VF | VERIFY IN FIELD |
| GR | GROUND | VWC | VINYL WALL COVERING |
| GYP | GYPSUM | WATER CLOSET | WATER CLOSET |
| HO | HOSE BIBB | WOW | WEIGHT |
| HOCP | HOLLOW CORE | WW | WITHOUT |
| HDWD | HARDWOOD | WP | WORK POINT |
| HDW | HARDWARE | W/W | WITHIN |
| HD | HEAD | W/I | WITHOUT |
| HFS | HIGH FULL SIZE | W/L | WITHIN |
| HM | HOLLOW METAL | W/L | WITHOUT |
| HORIZ | HORIZONTAL | WATERPROOF (ING) | WATERPROOF (ING) |
| HP | HORSEPOWER | WR | WEIGHT RESISTANT |
| HT | HEIGHT | WWF | WELDED WIRE FABRIC |
| HVAC | HEATING, VENTILATION, AIR CONDITIONING | WOR POINT | WORK POINT |
| HYD | HYDRANT | WP | WORK POINT |
| 12" | 12" = 1'-0" | XX | XX |

| | | | | | | | | | | | | | |
|-------|--------------------------------|---------------------|---------------------------------|--------------------------------|-------------|-------------------|---------------------------------------|---------------------------------------|-------------------------------|-------------------------------|-----------------------------|-----------------------------|-------------------------------------|
| GRASS | COMPACTED EARTH FILL (SECTION) | ROCK FILL (SECTION) | COMMON BRICK (PLAN AND SECTION) | TYPICAL CMU (PLAN AND SECTION) | CEILING FAN | CEILING FAN ABOVE | WALL MOUNTED SUPPLY DIFFUSER. SEE MEP | WALL MOUNTED RETURN DIFFUSER. SEE MEP | HVAC SUPPLY AIR SLOT. SEE MEP | HVAC RETURN AIR SLOT. SEE MEP | HVAC SUPPLY GRILLE. SEE MEP | HVAC RETURN GRILLE. SEE MEP | HVAC RETURN/EXHAUST GRILLE. SEE MEP |
| GRASS | COMPACTED EARTH FILL (SECTION) | ROCK FILL (SECTION) | COMMON BRICK (PLAN AND SECTION) | TYPICAL CMU (PLAN AND SECTION) | CEILING FAN | CEILING FAN ABOVE | WALL MOUNTED SUPPLY DIFFUSER. SEE MEP | WALL MOUNTED RETURN DIFFUSER. SEE MEP | HVAC SUPPLY AIR SLOT. SEE MEP | HVAC RETURN AIR SLOT. SEE MEP | HVAC SUPPLY GRILLE. SEE MEP | HVAC RETURN GRILLE. SEE MEP | HVAC RETURN/EXHAUST GRILLE. SEE MEP |
| GRASS | COMPACTED EARTH FILL (SECTION) | ROCK FILL (SECTION) | COMMON BRICK (PLAN AND SECTION) | TYPICAL CMU (PLAN AND SECTION) | CEILING FAN | CEILING FAN ABOVE | WALL | | | | | | |



CIVIL
DALLY + ASSOCIATES
9800 RICHMOND AVE SUITE 460
HOUSTON, TEXAS 77042
Civil Contact

LANDSCAPE
KW LANDSCAPE ARCHITECTS
6925 PORTWEST DRIVE, SUITE 100
HOUSTON, TX 77024
Landscape Contact


**STRUCTURAL
DALLY + ASSOCIATES
9800 RICHMOND AVE, SUITE 460
HOUSTON, TEXAS 77042
Structural Contact**

MEP
ASEI ENGINEERING
350 GLENBOROUGH DR, SUITE 270
HOUSTON, TX 77067
MEP Contact

**BUILDING ENVELOPE
PRICE CONSULTING, INC
211 HIGHLAND CROSS DRIVE SUITE
200 HOUSTON, TX 77073
Consultant Contact**

AV/IT CONSULTANT
DATACOM DESIGN GROUP
9111 JOLLYVILLE ROAD, SUITE 290
AUSTIN, TX 78759
Consultant Contact

KEYPLAN

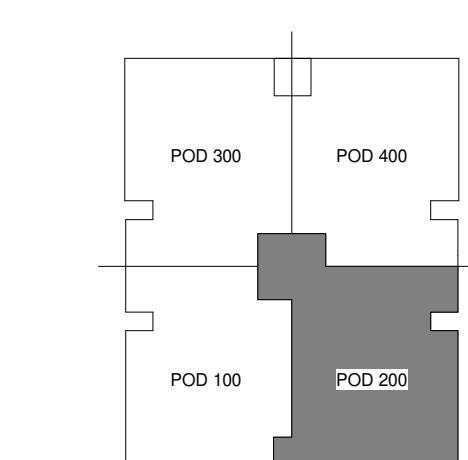

Ownership of Instruments of Service:
All reports, plans, specifications, computer files, field data, notes & other documents and instruments prepared by BRAVE / ARCHITECTURE as instruments of service shall remain the property of BRAVE / ARCHITECTURE. BRAVE / ARCHITECTURE shall retain all common law, statutory and other reserved rights, including the copyright thereto.

SEAL:




FILE:

| | |
|---------------|-----------------------------|
| DRAWN BY: | Auth. |
| CHECKED BY: | Check |
| ISSUE: | |
| 05/02/2024 | SCHEMATIC DESIGN |
| 06/14/2024 | DESIGN DEVELOPMENT |
| 08/23/2024 | 90% CONSTRUCTION DOCUMENTS |
| 09/23/2024 | 100% CONSTRUCTION DOCUMENTS |

ENLARGED FLOOR PLAN - POD 300

Scale: AS NOTED

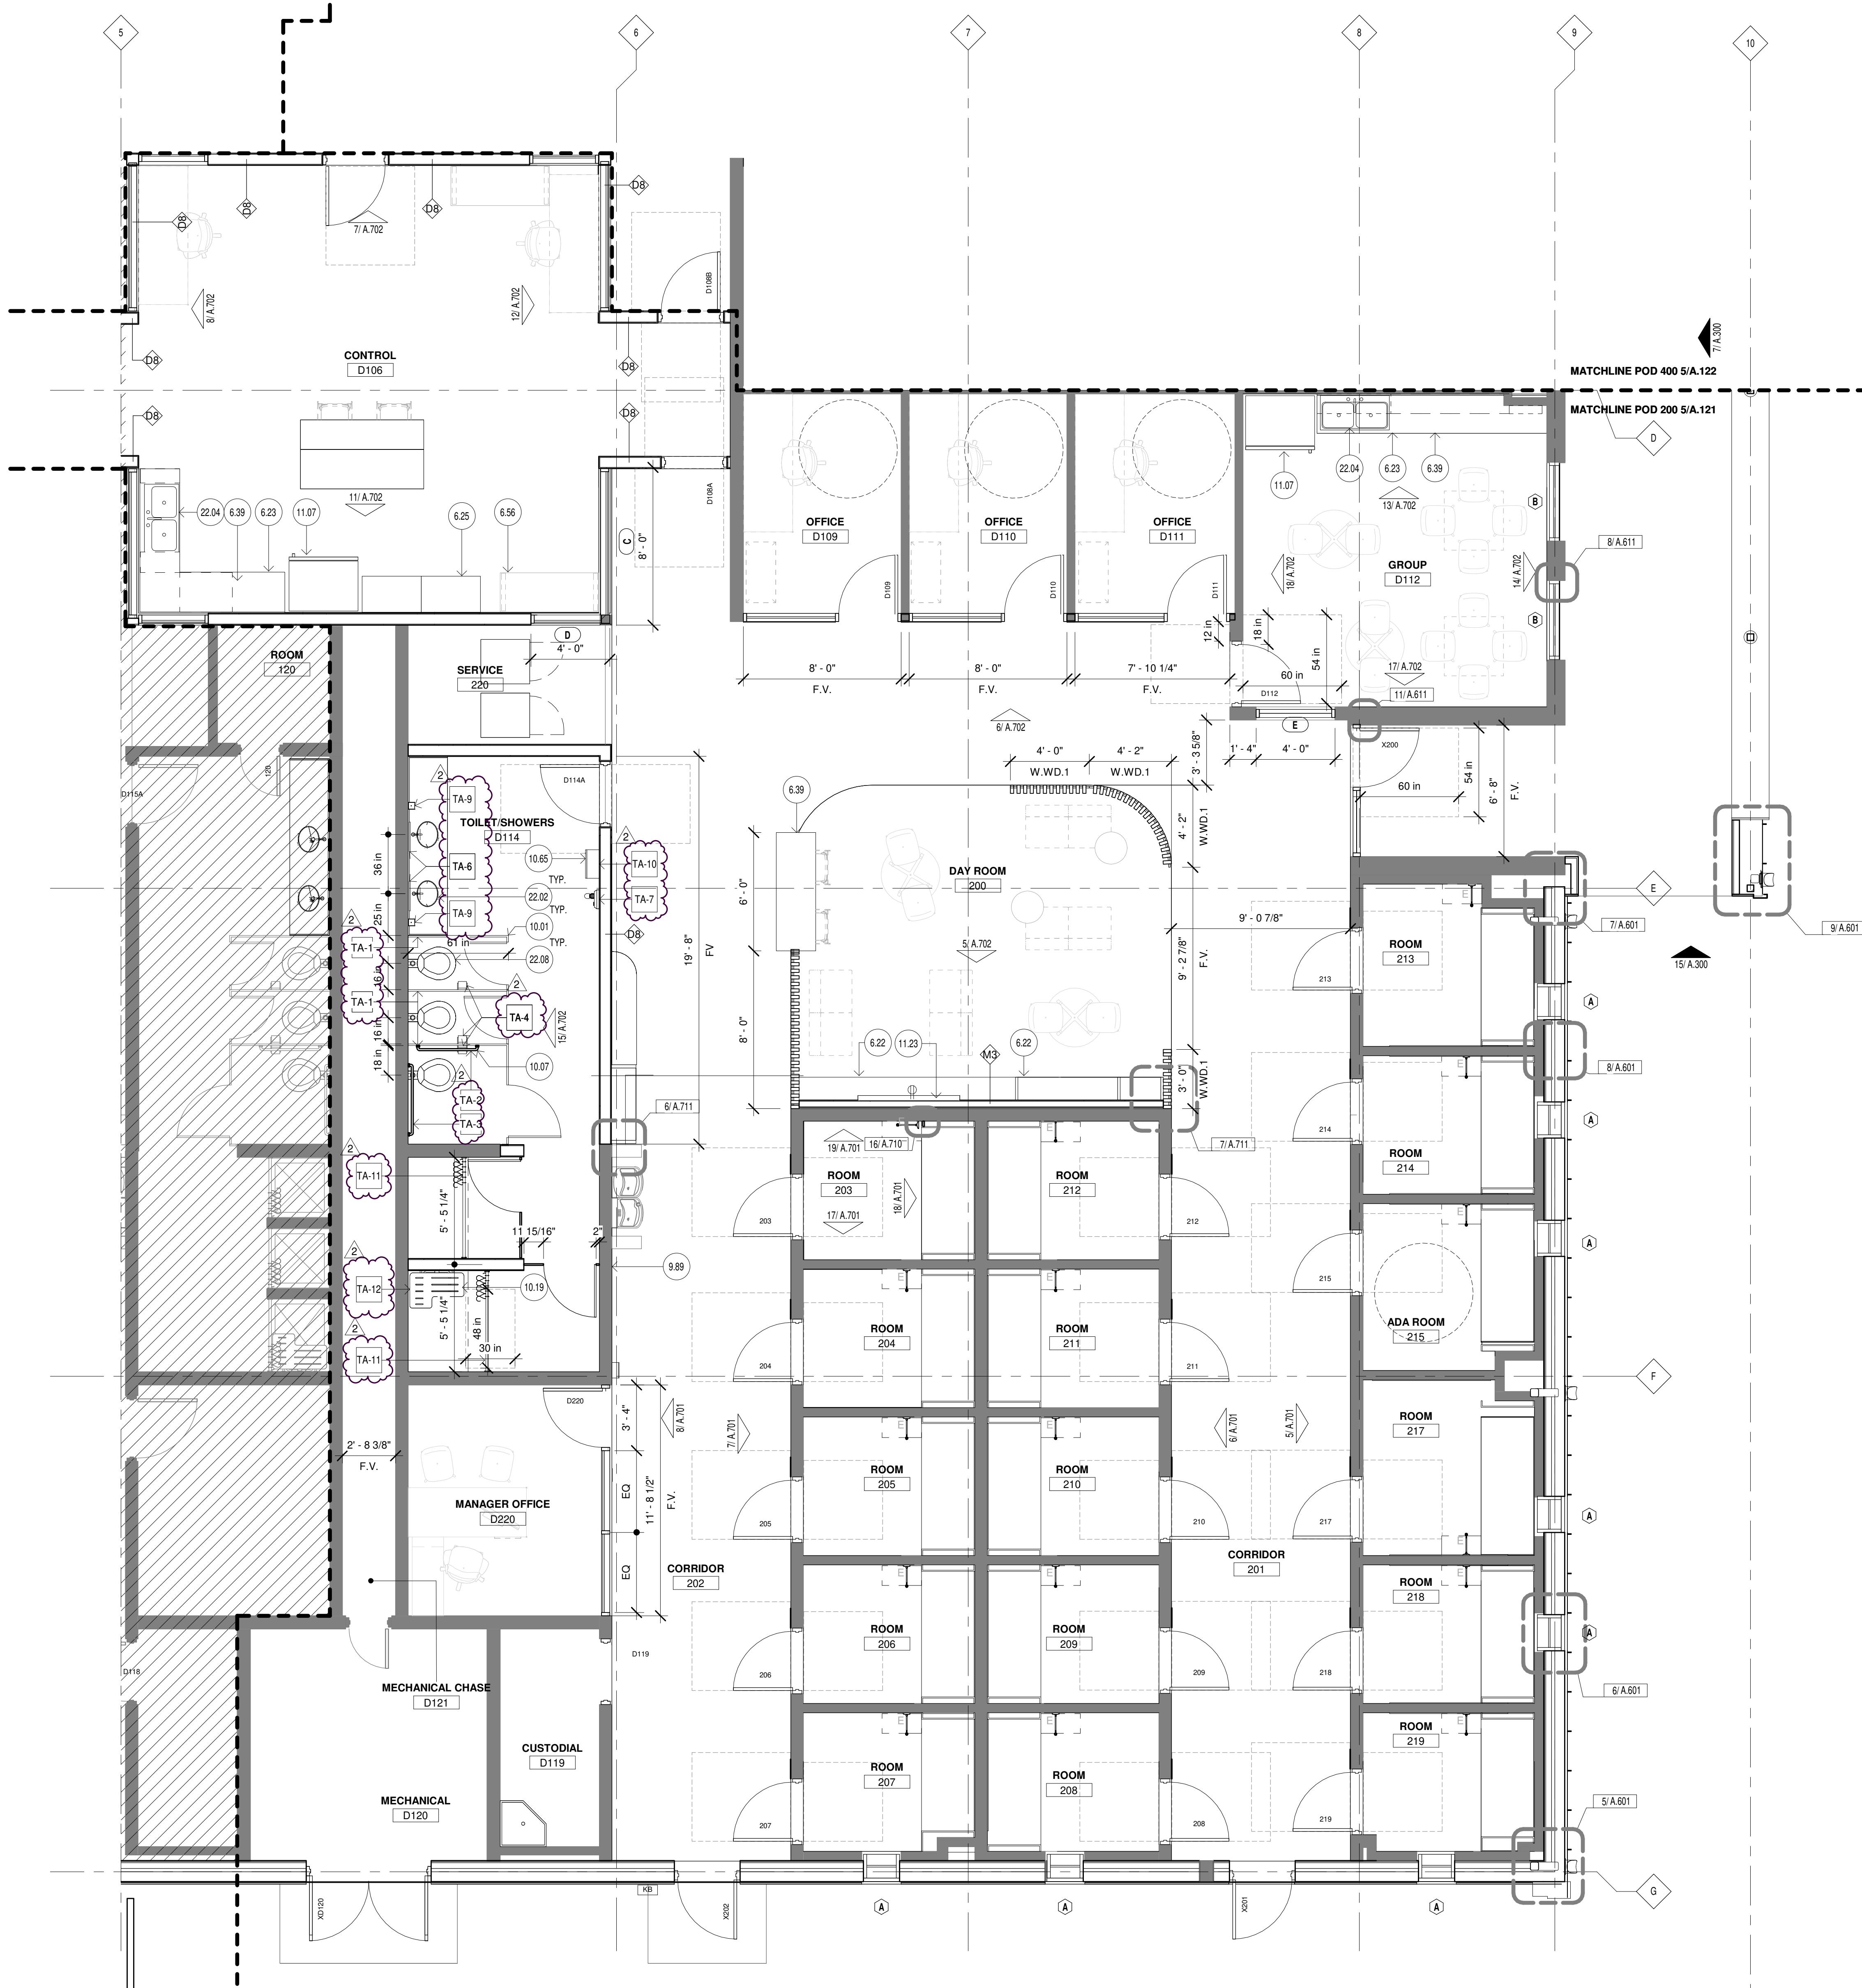

ENLARGED FLOOR PLAN - POD 200


1/4" = 1'-0" 5 LEGEND

1

A.I.O.I



KEYPLAN:

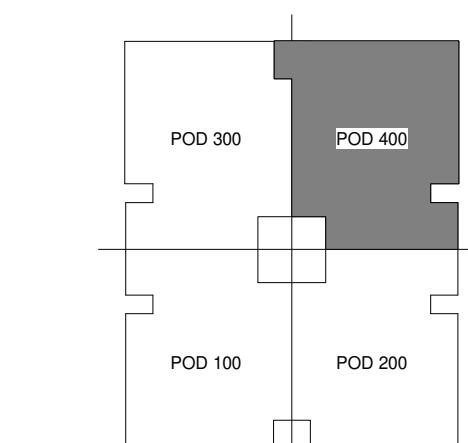


Ownership of Instruments of Service:
All instruments of service, including but not limited to, blueprints, plans, drawings, specifications, notes, data, reports, and other documents and instruments prepared by BRAVE ARCHITECTURE as instruments of service, shall remain the property of BRAVE ARCHITECTURE. BRAVE ARCHITECTURE shall retain all common law, statutory and other reserved rights, including the copyright thereto.

SEAL:



10/30/2024
FILE: DRAWN BY: CHECKED BY: Author Checker


ISSUE:
05/02/2024 SCHEMATIC DESIGN
06/14/2024 DESIGN DEVELOPMENT
08/23/2024 90% CONSTRUCTION DOCUMENTS
09/23/2024 100% CONSTRUCTION DOCUMENTS
2 11/05/2024 ADDENDUM #02

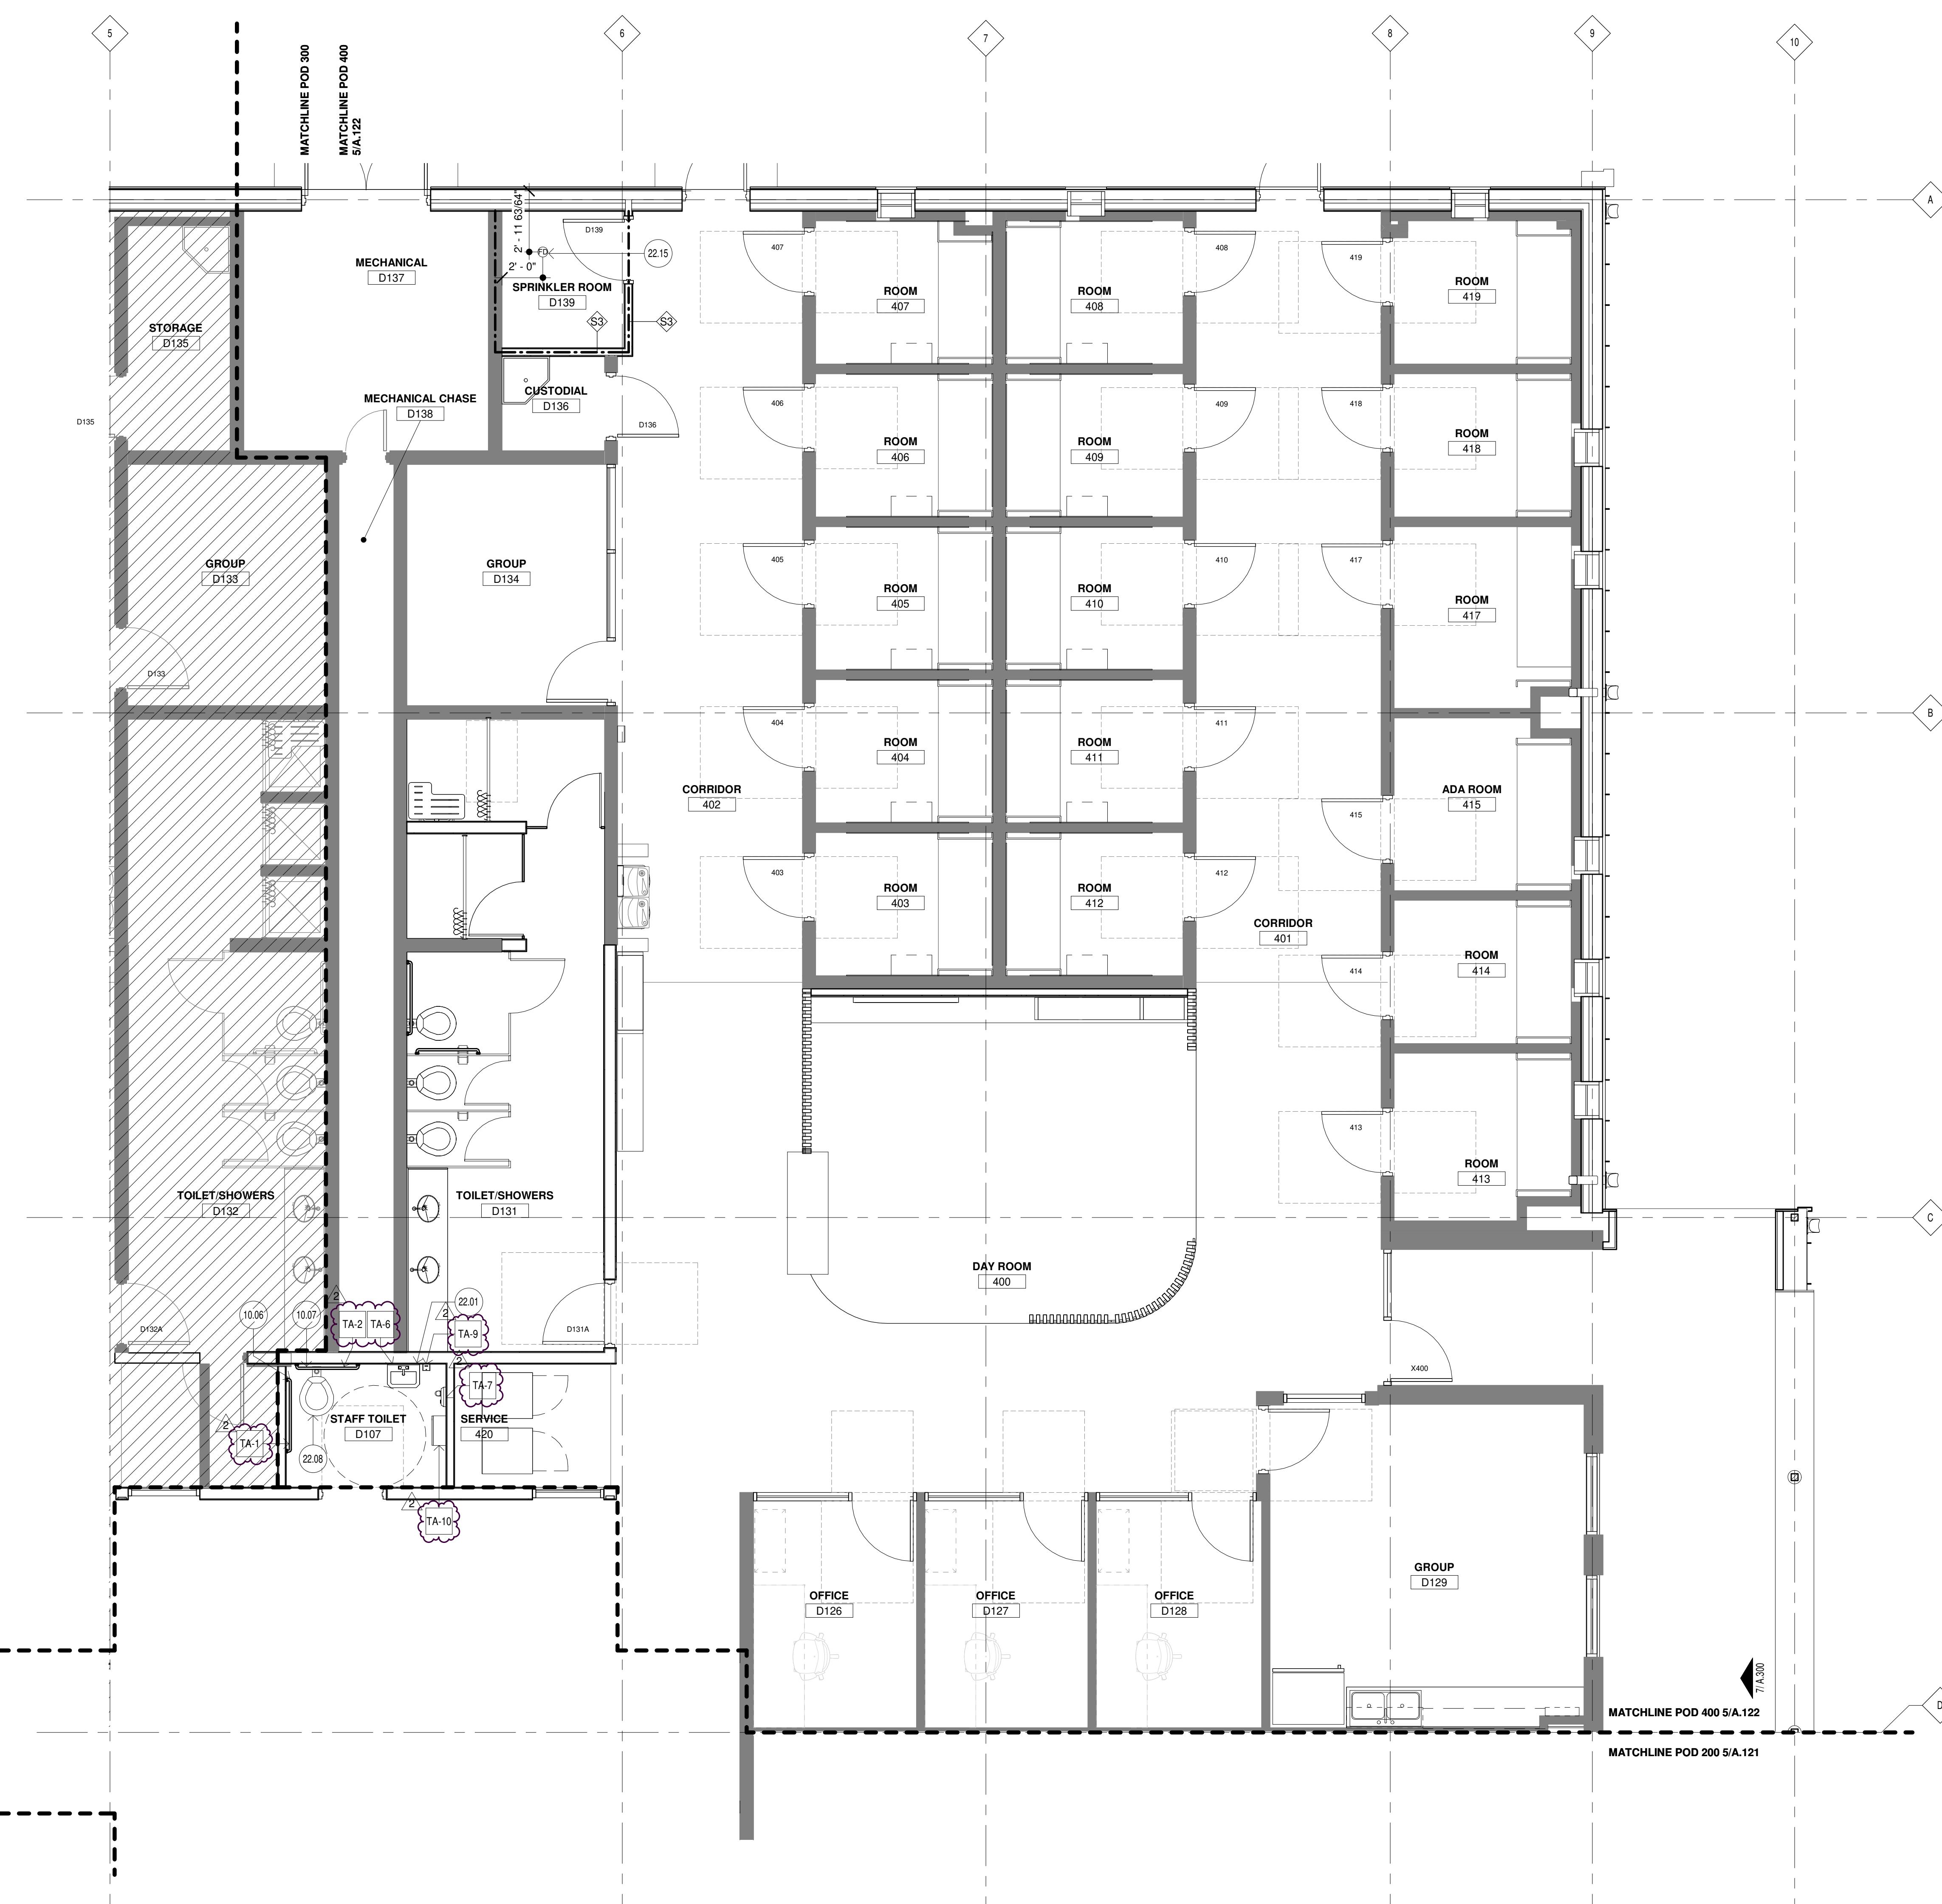

1/4" = 1'-0" 5 LEGEND 1

ENLARGED FLOOR PLAN - POD 400
NOTES:
1. POD 400 IS SIMILAR AS POD 200. ALL KEY NOTES, DIMENSIONS AND SCOPE OF WORK APPLIES FROM SHEET A.101, UNLESS NOTED OTHERWISE. REFER TO SHEET A.101 FOR CONTROL ROOM INFORMATION.
2. REFER TO TYPICAL NOTES FOR NEW CONSTRUCTION IN ALL PODS, U.N.O.
3. FURNITURE AND EQUIPMENTS ARE SHOWN FOR REFERENCE ONLY. THEY ARE TO BE PROVIDED BY THE OWNER.
4. ALL DIMENSIONS TO BE FIELD VERIFIED

Scale: AS NOTED

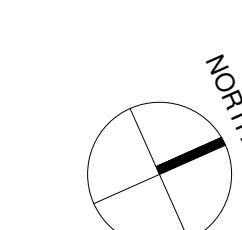

ENLARGED FLOOR PLAN - POD 400



CIVIL
DALLY + ASSOCIATES
9800 RICHMOND AVE SUITE 460
HOUSTON, TEXAS 77042
Civil Contact

LANDSCAPE
KW LANDSCAPE ARCHITECTS
6925 PORTWEST DRIVE, SUITE 100
HOUSTON, TX 77024
Landscape Contact

**STRUCTURAL
DALLY + ASSOCIATES
9800 RICHMOND AVE, SUITE 460
HOUSTON, TEXAS 77042
Structural Contact**

MEP
ASEI ENGINEERING
350 GLENBOROUGH DR, SUITE 270
HOUSTON, TX 77067
MEP Contact

**BUILDING ENVELOPE
PRICE CONSULTING, INC
211 HIGHLAND CROSS DRIVE SUITE
200 HOUSTON, TX 77073
Consultant Contact**

**AV/IT CONSULTANT
DATACOM DESIGN GROUP
9111 JOLLYVILLE ROAD, SUITE 290
AUSTIN, TX 78759
Consultant Contact**

Ownership of Instruments of Service:
All reports, plans, specifications, computer files, field data, notes & other documents and instruments prepared by BRAVE / ARCHITECTURE as instruments of service shall remain the property of BRAVE / ARCHITECTURE. BRAVE / ARCHITECTURE shall retain all common law, statutory and other reserved rights, including the copyright thereto.

SEAL:

REGISTERED ARCHITECT
FERNANDO L. BRAVE
14292
STATE OF TEXAS
S.A.

L.B. BRAVE.

10/30/2024

10/30/2024
FILE: _____
DRAWN BY: _____ EH
CHECKED BY: _____ MM

ISSUE:
05/02/2024 SCHEMATIC DESIGN
06/14/2024 DESIGN DEVELOPMENT
08/23/2024 90% CONSTRUCTION
DOCUMENTS
09/23/2024 100% CONSTRUCTION
DOCUMENTS

11/01/2024 ADDENDUM # 01
11/05/2024 ADDENDUM #02

FINISH SCHEDULE

Scale: AS NOTED

| EXTERIOR FINISH SCHEDULE | | | | | | |
|--------------------------|--------------|-------------------|---------------------|---------------------|--------------|--|
| FINISH MARK | ITEM | MANUFACTURER | MANUFACTURER NUMBER | MANUFACTURER NAME | FINISH | COMMENTS |
| MP.1 | METAL PANEL | MORIN | | VARIES | BONE WHITE | MORIN PANELS MATRIX-3, MATRIX-4, AND MATRIX-10 TO BE USED. SEE 4/A.301 FOR PATTERN |
| MP.2 | METAL PANEL | MCELROY METAL | | 238-T | CHARCOAL | 238T WALL SYSTEM TO BE APPLIED TO ROOF AND WALLS, 24" WIDE PANELS |
| MP.3 | METAL PANEL | MCELROY METAL | | VISIONLINE F-SERIES | SURREY BEIGE | |
| STC.1 | STUCCO | | | | SMOOTH | 3 LAYER PORTLAND CEMENT PLASTER, PAINTED. COLOR TO BE SELECTED BY ARCHITECT |
| PT.1 | KYNAR FINISH | | | | SMOOTH | COLUMN COVER - COLOR TO BE SELECTED BY ARCHITECT |
| PT.2 | PAINT | SHERWIN WILLIAMS | | | | ACCENT PAINT |
| WD.1 | IPE WOOD | US LUMBER BROKERS | | | | 1 X 6 IPE PLANKS, STAIN GRADE; GC TO PROVIDE 3 STAIN SAMPLES |

FINISH SCHEDULE - EXTERIOR

8

| FINISH SCHEDULE | | | | | | | |
|-----------------|------------------------------------|------------------|---------------------|-----------------------|----------------------|---|--|
| FINISH MARK | ITEM | MANUFACTURER | MANUFACTURER NUMBER | MANUFACTURER NAME | FINISH | COMMENTS | |
| FLOOR | | | | | | | |
| F.EP.1 | EPOXY FLOOR | | | | | TOILET/SHOWER ROOMS | |
| F.CONC.1 | SEALED CONCRETE | | | | | ALL FLOORS TO BE F.CONC.1 U.N.O. | |
| F.LVT.1 | LUXURY VINYL TILE | TARKETT | 0976 | CONTOUR | WOVEN REED SILKSTRAW | CORRIDORS/GROUP ROOMS/CONTROL ROOM | |
| F.LVT.2 | LUXURY VINYL TILE | TARKETT | C127 | COLOR POP | BERMUDA | DAYROOM 200 | |
| F.LVT.3 | LUXURY VINYL TILE | TARKETT | C177 | COLOR POP | SUNBEAM | DAYROOM 400 | |
| F.SV.1 | SHEET VINYL | TARKETT | 0296 | IQ GRANIT | WARM GREY | SLEEPING UNITS | |
| BASE | | | | | | | |
| B.RB.1 | RUBBER BASE | TARKETT | TSB25 | JOHNSONITE | FAWN | 4" RUBBER BASE | |
| B.SV.1 | SHEET VINYL | TARKETT | 0296 | IQ GRANIT | WARM GREY | SLEEPING UNITS | |
| B.EP.1 | EPOXY BASE | | | | | | |
| WALL | | | | | | | |
| W.PT.1 | PAINT 1 | SHERWIN WILLIAMS | SW7757 | HIGH REFLECTIVE WHITE | SEMI GLOSS | ALL WALLS TO BE W.PT.1 U.N.O. | |
| W.PT.2 | ACCENT PAINT | SHERWIN WILLIAMS | SW6759 | COOLED BLUE | SEMI GLOSS | POD 200 | |
| W.PT.3 | ACCENT PAINT | SHERWIN WILLIAMS | SW9019 | GOLDEN PLUMERIA | SEMI GLOSS | POD 400 | |
| W.WD.1 | WOOD SLAT WALL | SLAT SOLUTIONS | | SLAT ROOM DIVIDER | MAPLE | | |
| W.CT.1 | CERAMIC TILE 4" X 10" | EMSER | | CATCH GLOSSY | ICE GLOSSY | TILE AT RESTROOMS, UP TO 8' AFF | |
| W.SV.1 | SHEET VINYL | TARKETT | 0296 | IQ GRANIT | WARM GREY | SLEEPING UNITS | |
| W.CG.1 | CORNER GUARD | INPRO | | INPRO | STAINLESS STEEL | 3 1/2" | |
| CEILING | | | | | | | |
| C.ACT.1 | 2' X 2' MINERAL WOOL CEILING TILES | ROCKFON | SLN | ALASKA | WHITE | | |
| C.PT.1 | PAINT 1 | SHERWIN WILLIAMS | SW7757 | HIGH REFLECTIVE WHITE | SEMI GLOSS | ALL CEILINGS TO BE C.PT.1 U.N.O. | |
| C.PT.2 | ACCENT PAINT | SHERWIN WILLIAMS | SW6759 | COOLED BLUE | SEMI GLOSS | POD 200 | |
| C.PT.3 | ACCENT PAINT | SHERWIN WILLIAMS | SW9019 | GOLDEN PLUMERIA | SEMI GLOSS | POD 400 | |
| MILLWORK | | | | | | | |
| M.PL.1 | PLASTIC LAMINATE 1 | WILSONART | 7987-38 | PALISADES OAK | FINE VELVET | | |
| M.PL.2 | MELAMINE | FORMICA | 459-58 | BRITE WHITE | MATTE FINISH | CABINET, SHELVING, AND DRAWER INTERIORS | |
| M.QZ.1 | QUARTZ | COSENTINO | | SILESTONE | ET STATUARIO | ALL COUNTERTOPS | |
| MISC. | | | | | | | |
| FT.1 | FELT ACOUSTICAL PANEL | ACOUFELT | PE20 | PEACOCK | SOLID, 12MM | TYP. IN POD 200, GC TO INSTALL WITH REQUIRED MOUNTING ACCESSORIES AS NEEDED FOR CEILING AND WALL/MOUNTING AS PER MANUFACTURER'S RECOMMENDATIONS | |
| FT.2 | FELT ACOUSTICAL PANEL | ACOUFELT | BU07 | BUTTER | SOLID, 12MM | TYP. IN POD 400, GC TO INSTALL WITH REQUIRED MOUNTING ACCESSORIES AS NEEDED FOR CEILING AND WALL/MOUNTING AS PER MANUFACTURER'S RECOMMENDATIONS | |

FINISH SCHEDULE - INTERIOR

6

| TOILET ACCESSORIES SCHEDULE | | | | | | |
|-----------------------------|----------------------------------|--------------|---|----------------|-------------------------|--|
| TAG | ITEM | MANUFACTURER | DESCRIPTION | MODEL | FINISH | COMMENTS |
| TA-1 | TOILET PARTITIONS | BOBRICK | STANDARD PRIVACY - FLOOR TO CEILING | | | TOILET ENCLOSURES AND ENTRANCE SCREENS |
| TA-2 | 36" GRAB BAR | BOBRICK | 1 1/2" DIAMETER GRAB BAR W/ SNAP FLANGE & PEENED GRIPPING SURFACE | B-6806.99 X 36 | STAINLESS STEEL SATIN | |
| TA-3 | 42" GRAB BAR | BOBRICK | 1 1/2" DIAMETER GRAB BAR W/ SNAP FLANGE & PEENED GRIPPING SURFACE | B-6806.99 X 42 | STAINLESS STEEL SATIN | |
| TA-4 | TOILET PAPER TISSUE DISPENSERS | TORK | DOUBLE-ROLL TOILET TISSUE DISPENSER | H-1347 | SMOKE | |
| TA-5 | SANITARY NAPKIN DISPOSAL | BOBRICK | CONTURA SERIES SANITARY NAPKIN DISPOSAL | B-270 | STAINLESS STEEL SATIN | |
| TA-6 | MIRROR | BOBRICK | FRAMED STAINLESS STEEL CHANNEL MIRROR | B-165 | STAINLESS STEEL SATIN | |
| TA-7 | HAND DRYER | EXCEL DRYER | XLERATOR HAND DRYER | XL-SB | BRUSHED STAINLESS STEEL | |
| TA-8 | COAT HOOK | BOBRICK | ROBE HOOK (DOUBLE) | B-6727 | STAINLESS STEEL SATIN | |
| TA-9 | SOAP DISPENSER | ECOLAB | SURFACE-MOUNTED SOAP DISPENSER | EL-92021192 | BLACK | |
| TA-10 | PAPER TOWEL AND TRASH RECEPTACLE | BOBRICK | SURFACE MOUNTED PAPER TOWEL DISPENSER AND WASTE RECEPTACLE | B-43699 | STAINLESS STEEL SATIN | |
| TA-11 | CURTAIN ROD | BOBRICK | CLASSIC SERIES EXTRA-HEAVY-DUTY SHOWER CURTAIN ROD | B-6107 X 36 | BOBRICK SATIN | |
| TA-12 | SHOWER SEAT | BOBRICK | REVERSIBLE FOLDING SHOWER SEAT | B-5181 | STAINLESS STEEL | |

NOTES:

- 1. TYPICAL NEW CONSTRUCTION NOTES, U.N.O.
- 2. REFERENCE A.150 FOR SPECIFIC POD FINISHES.
 - POD 200: F.LVT.2, W.PT.2, C.PT.2, AND FT.1
 - POD 400: F.LVT.3, W.PT.3, C.PT.3, AND FT.2
- 3. GC TO REFERENCE A.730 FOR MOUNTING HEIGHTS

5 LEGEND

A. 150

A.150

